



HORNBY STREET

WEST HASTINGS STREET

LANE

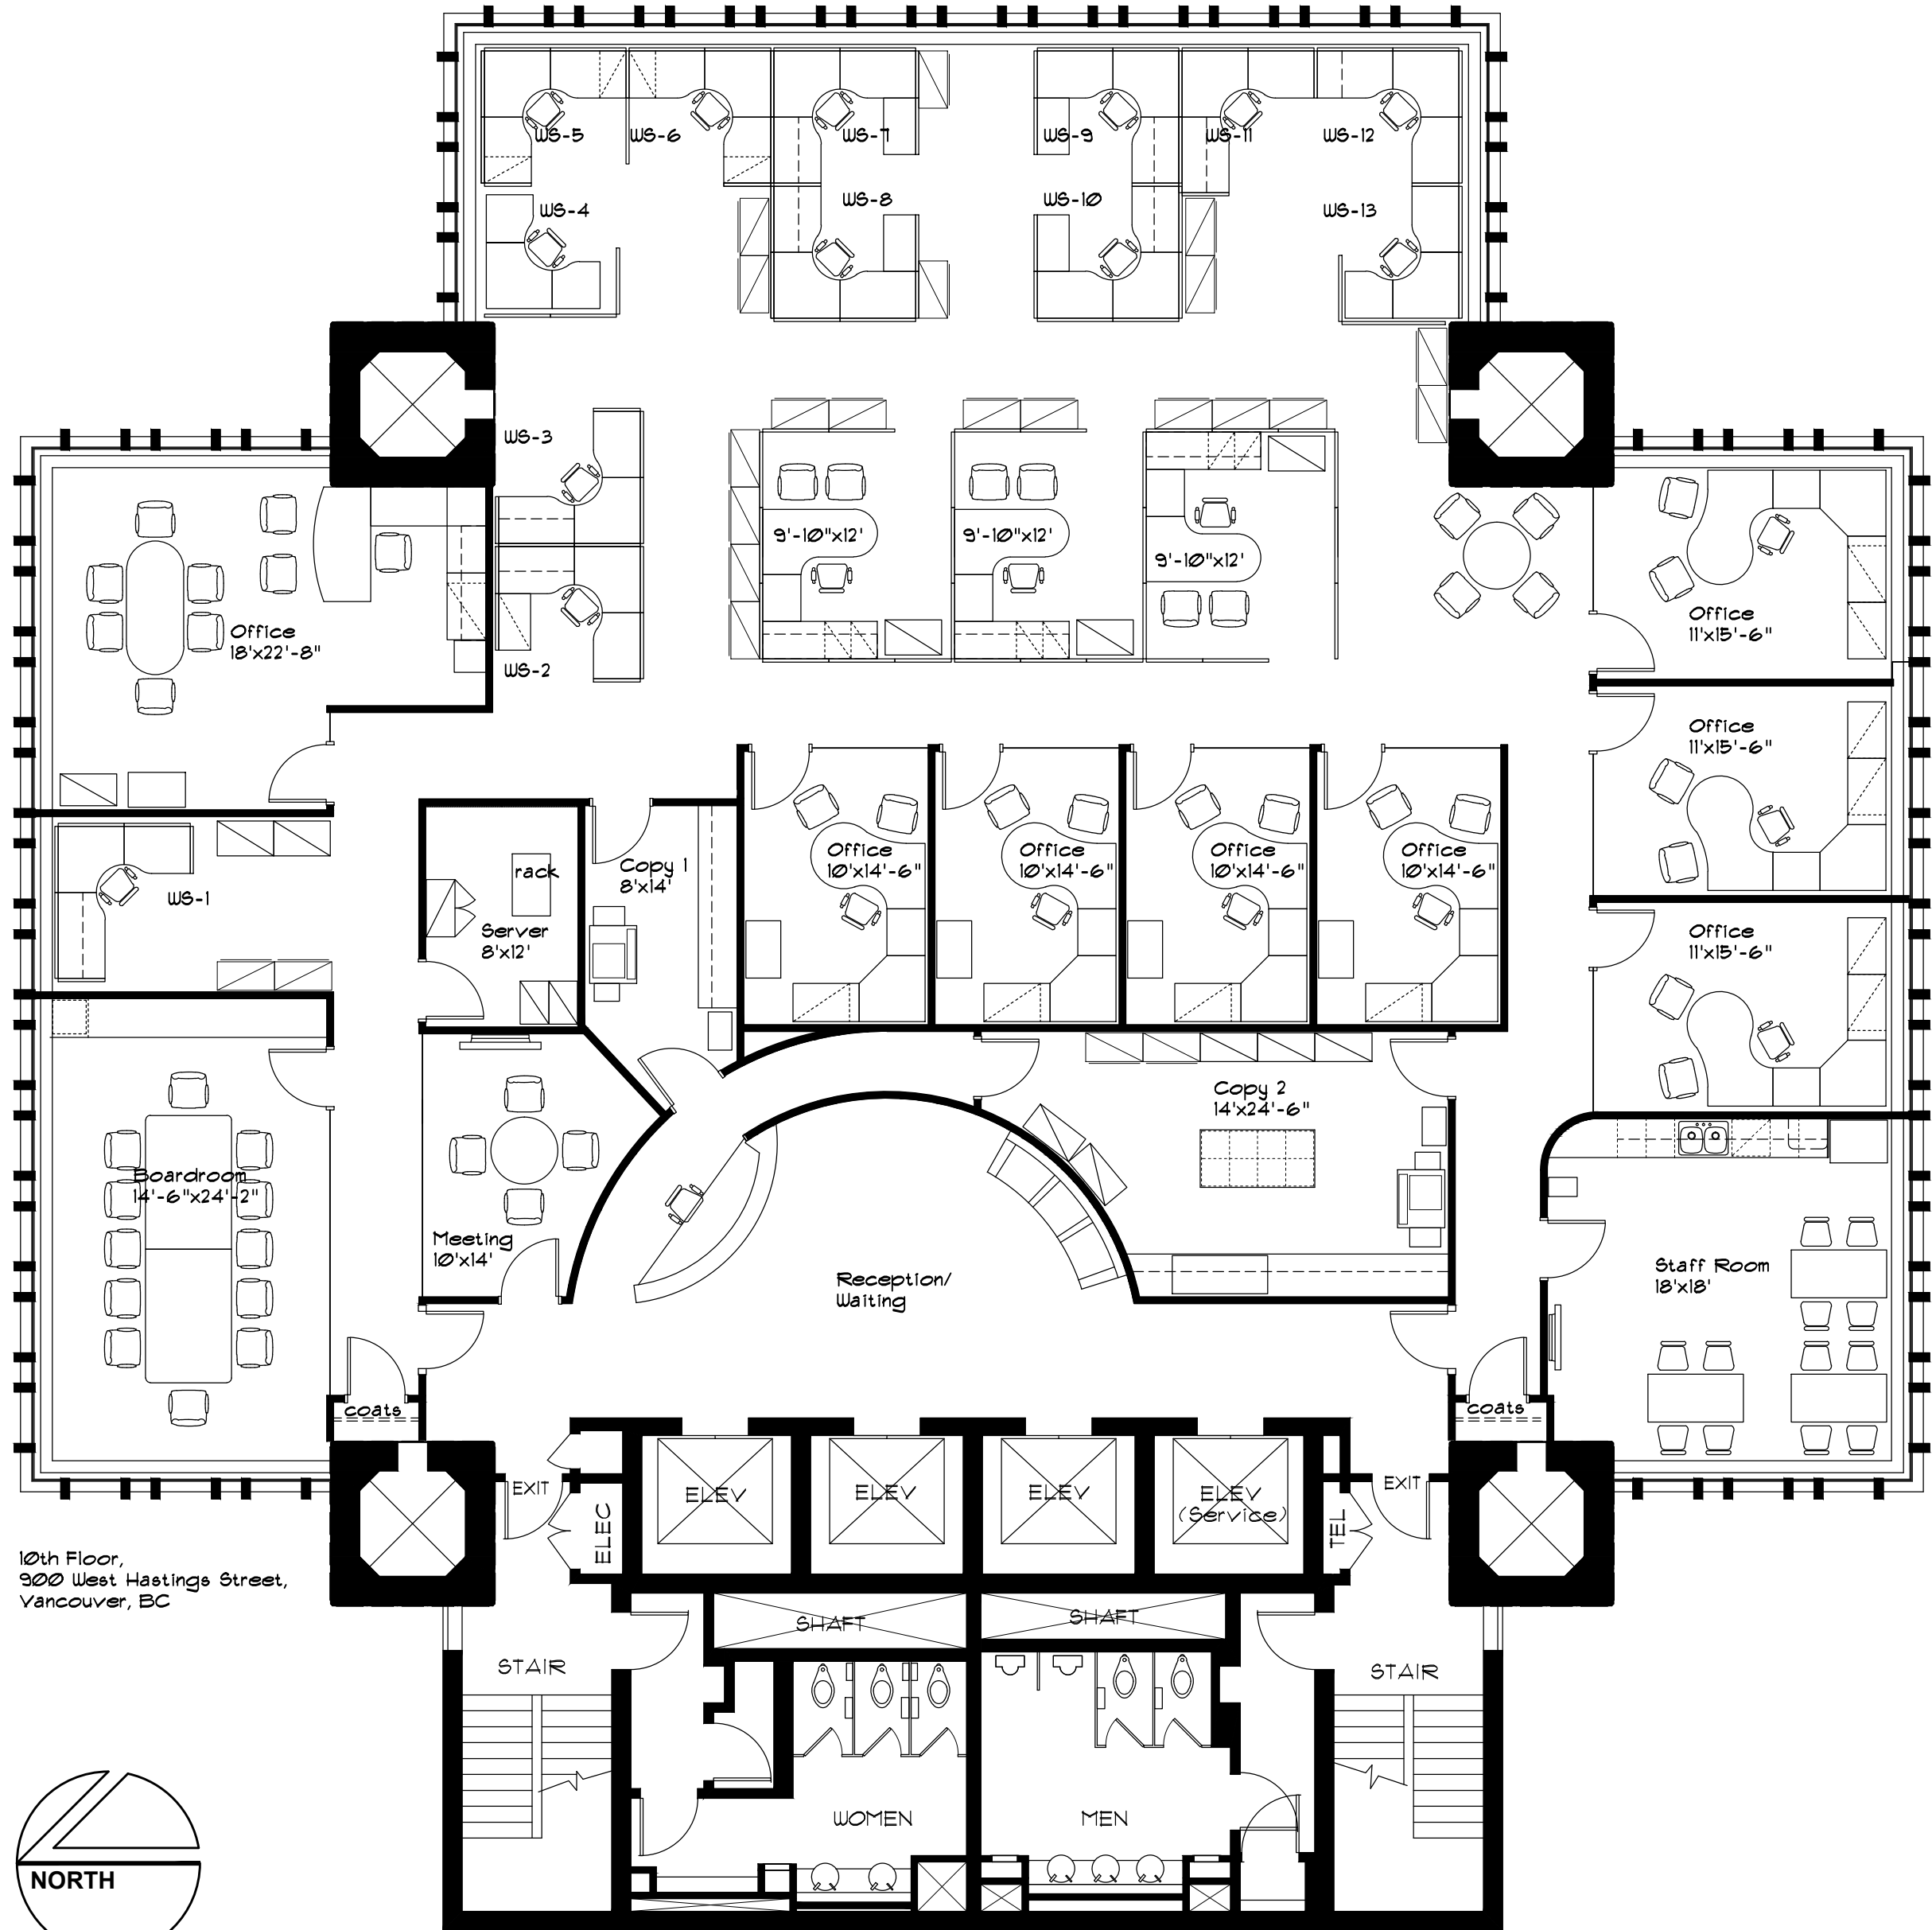

10th Floor,
900 West Hastings Street,
Vancouver, BC

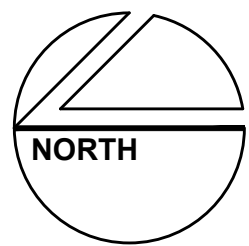

LANE